AS-BUILT DAMAGE SKETCH

EQC
EARTHQUAKE COMMISSION
Kōmihana Rūwhenua

Customer Address : _____

Customer EQC Claim # _____

Contractor Name _____

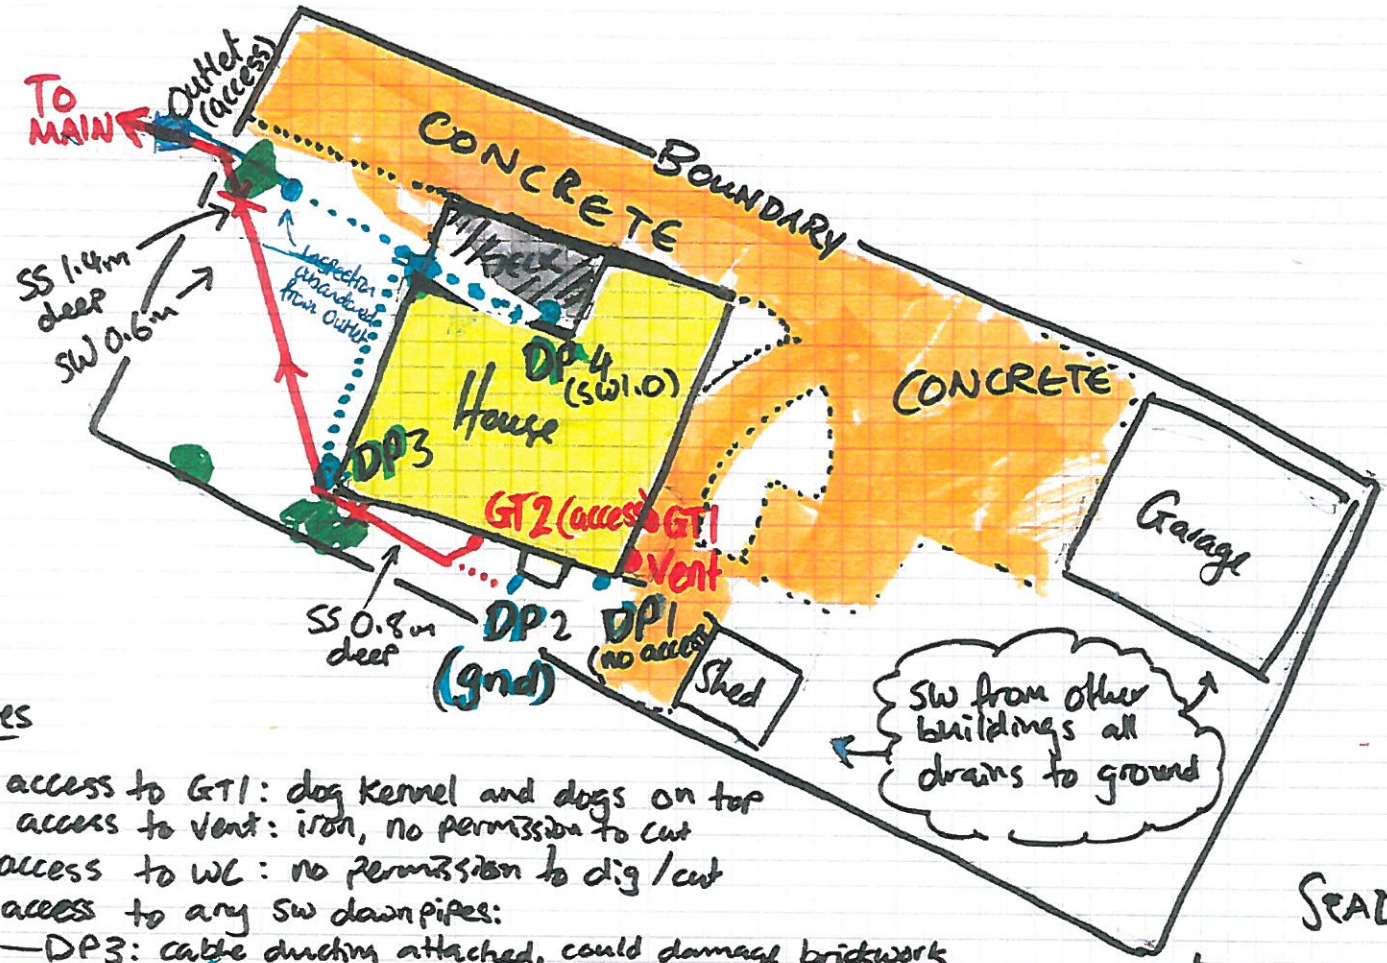

Key

- Existing Sewer Line
- Existing Stormwater Line
- Pavers / Driveway
- Earthquake Damage
- Kerb Outlet
- Downpipe / Toilet Vent
- SUMP
- Trees

Abbreviations

- Kerb Outlet - KO
- SUMP
- Down Pipe (S/W) - DP
- Boundary Inspectiomn Pipe
- Type of Material
  - Earthenware - EW
  - Poly Vinyl Chloride - PVC
  - C/I - Cast Iron
- Bends - show upstream direction
  - Left hand bend - LHB
  - Right Hand Bend - RHB
  - Inspection Bend - IB
  - Left Hand Inspection Bend - LHIB
  - Right Hand Inspection Bend - RHIB
- Junction
  - Left Hand Junction - LHJ
  - Right Hand Junction - RHJ
  - Inspection Junction - IJ
  - Inspection Left Junction - ILJ
  - Inspection Right Junction - IRJ
- Fixtures
  - Gully Trap - GT
  - Terminal Vent - TV
  - Main Vent - MV
  - Toilet - WC

Notes

- no access to GT1: dog kennel and dogs on top
- no access to Vent: iron, no permission to cut
- no access to WC: no permission to dig / cut
- no access to any SW downpipes:
  - DP3: cable ducting attached, could damage brickwork
  - DP1: cemented, no permission to cut
  - DP4: under wooden deck
- access to part of SW line from outlet, but abandoned due to massive RI